


AS SEEN FROM REAR

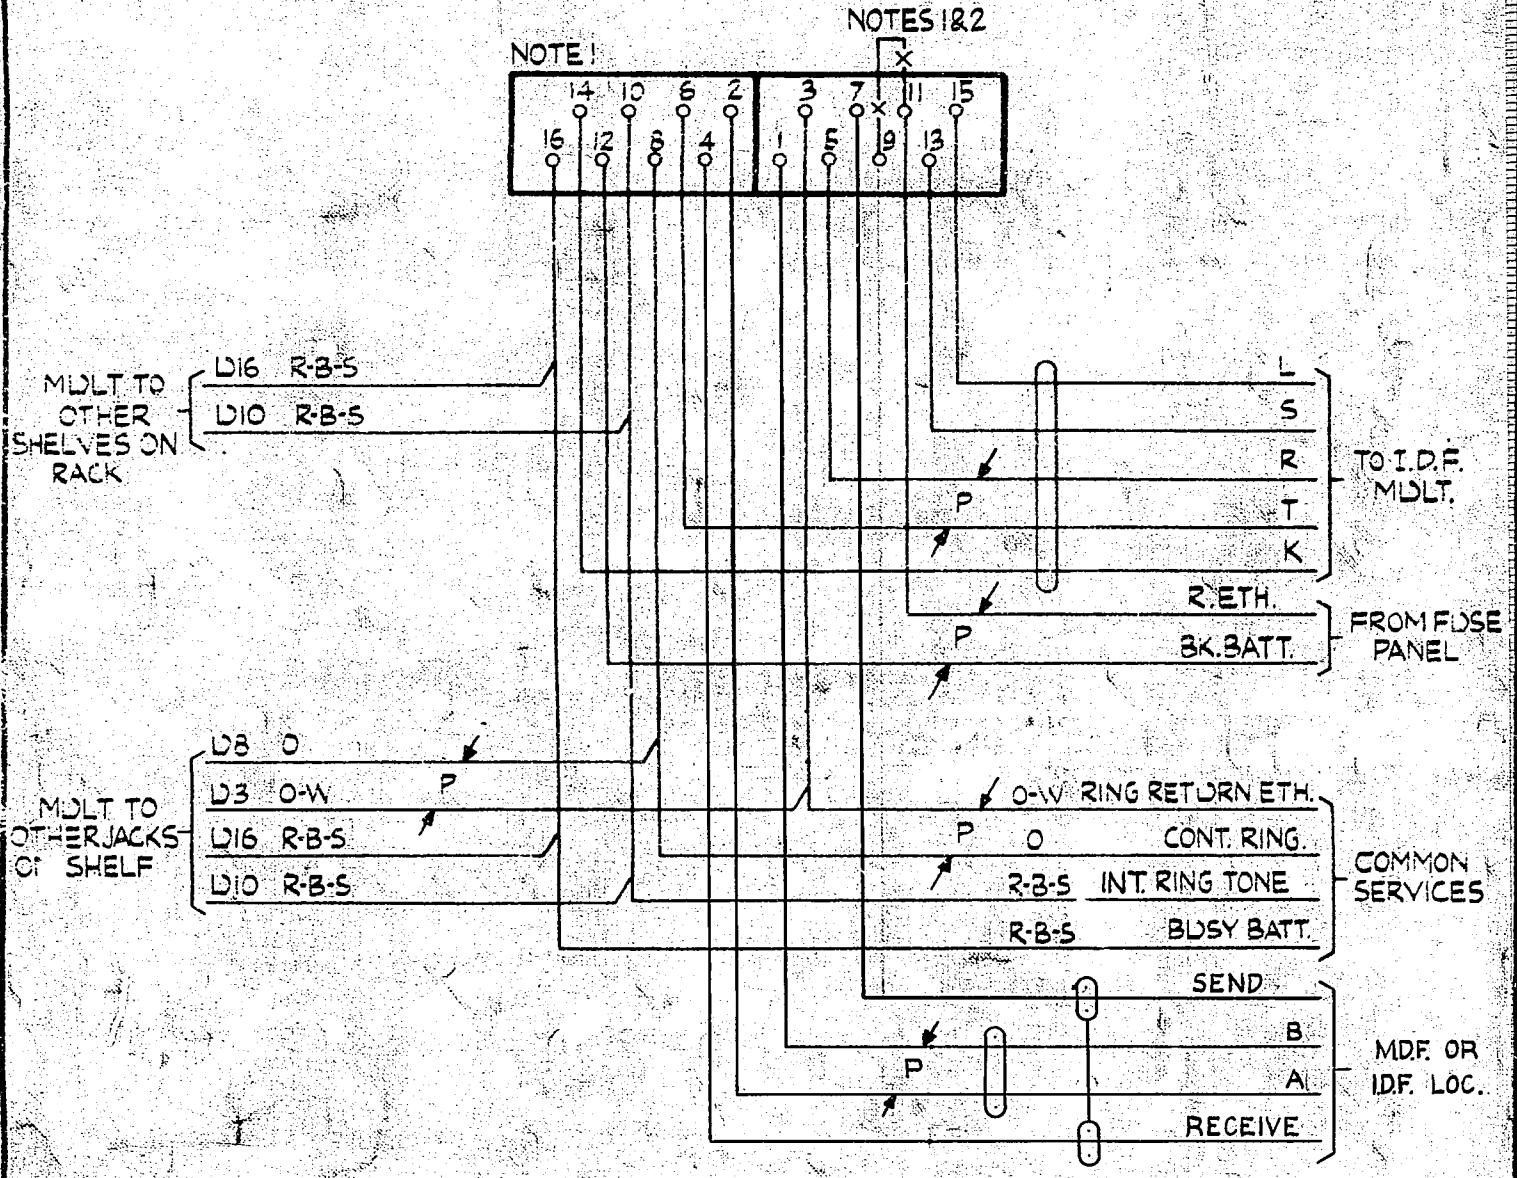

NOTES:-

1. IN ADDITION TO SHELF JACK POINTS D9 & D11, D14 & D16 TO MAKE CONTACT WHEN RELAY SET IS REMOVED.
2. STRAP D9 & D11 WHEN CCT. IS ASSOC? WITH UNDER 3DB UNREPEATERED LINE.
3. ALL WIRING TO BE 20 S.W.G. UNLESS OTHERWISE SPECIFIED.

FU HAWERA ONLY

SLEEVE CONTROL SYSTEM  
TRUNK SUBSCRIBER C.B  
WITH BALLAST RESISTANCE  
2000 TYPE

SEND & REC LEADS PROVIDED U7, U4 (86321) A 26-9-69 RW

AMENDMENT PARTICULARS

ISSUE DATE APP? REF -

50V

N.Z.P.O.

DRAWN CHECKED WIRING CIRCUIT  
7/1 50% RW

GBU 13050 MOD B